

IF THIS DRAWING IS NOT 24" x 36" IN SIZE
A REDUCED PRINT SCALE ACCORDINGLY

JUSTIN PC ARCHITECTS
205 LEXINGTON AVE
NEW YORK, NY 10018
TEL (212) 688 9000

JOHN C. WESTRICK & ASSOCIATES
CONSULTING ENGINEERS
210 MAPLEAVE, SOUTH PLAINFIELD, N.J.
07080 201 581-5776

DATE	ISSUED TO	PR	TR
3/12/91	FOR AUTHORITY OF APPROVAL	10	1
3/17/91	CPSC FOR RECORD	5	4
3/19/91	CFSC	1	1
5/3/91	P.A. FOR APPROVAL	10	2
5/22/91	SSS MEETL	5	1
6/7/91	CPSC	7	1
10/21/91	P.A. "AS BUILT DRAWING"	-	1

AS BUILT DRAWING

Signature: [Signature]
DATE: 8-6-91
JUSTIN PC ARCHITECTS

Δ	8-6-91	REVISED TO SHOW AS BUILT CONDITIONS	JRP
Δ	1/10/91	ADDED HANDRAIL FOR PORT AUTHORITY COMMENTS	TL
NO	DATE	REVISION	BY

CANTOR, FITZGERALD
SECURITIES CORP.
105TH FLOOR
ONE WORLD TRADE CENTER, NEW YORK, N.Y.

PROPOSED NEW TRADING ROOM
FOR INVESTMENT STRATEGIES
CONSTRUCTION PLAN

PROJECT NO. 700
SCALE 1/4" = 1'-0"
DRAWN BY J.R.P.
CHECKED BY J.R.P.
DATE MARCH 22, 1991

DRAWING NO.


105P

5


LEGEND

- SPACE NUMBER SYMBOL
- DOOR NUMBER SYMBOL
- ELEVATION SYMBOL
- DETAIL SYMBOL
- FLOOR ELEVATION ABOVE
- EXISTING CONSTRUCTION
- EXISTING CONSTRUCTION TO BE REMOVED
- NEW 2 1/2" STEEL STUDS WITH 5/8" GYPSUM BOARD BOTH SIDES FROM TOP OF RAISED ACCESS FLOOR. SEE DWG. 105P-6
- NEW 2 1/2" STEEL STUDS WITH 5/8" GYPSUM BOARD BOTH SIDES FROM TOP OF CONCRETE SLAB. SEE DWG. 105P-6
- NEW LOW PARTITION, 2 1/2" STEEL STUDS WITH 5/8" GYPSUM BOARD BOTH SIDES & HARDWOOD CAP. SEE DWG. 105P-6
- EXISTING 2'x2'x2" RAISED ACCESS FLOOR PANELS (NO CHANGE)
- NEW OR RELOCATED 2'x2'x2" RAISED ACCESS FLOOR PANELS. REUSE PANELS REMOVED FROM PIT AREA & PROVIDE ADDITIONAL PANELS REQUIRED TO COMPLETE INSTALLATION.
- NEW METAL & GLASS PARTITION TO CEILING. ACCESS STATE PARTITION #250. SEE DRAWING 105P-6


FRAME TYPES

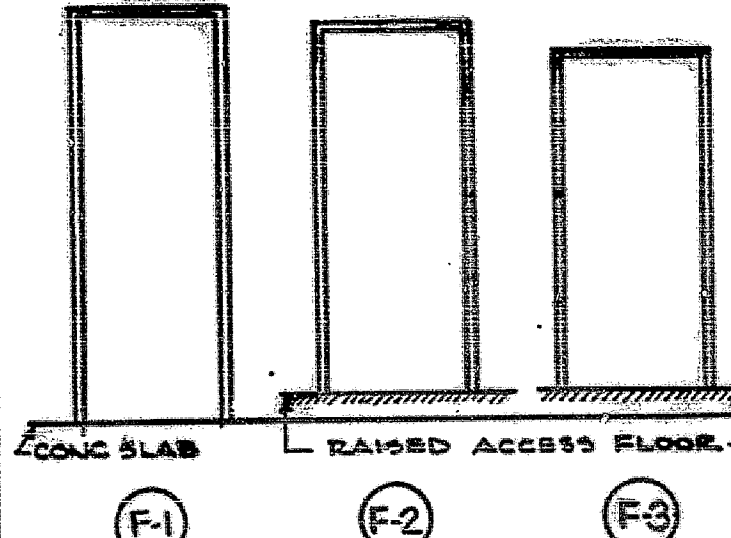

DOOR TYPES

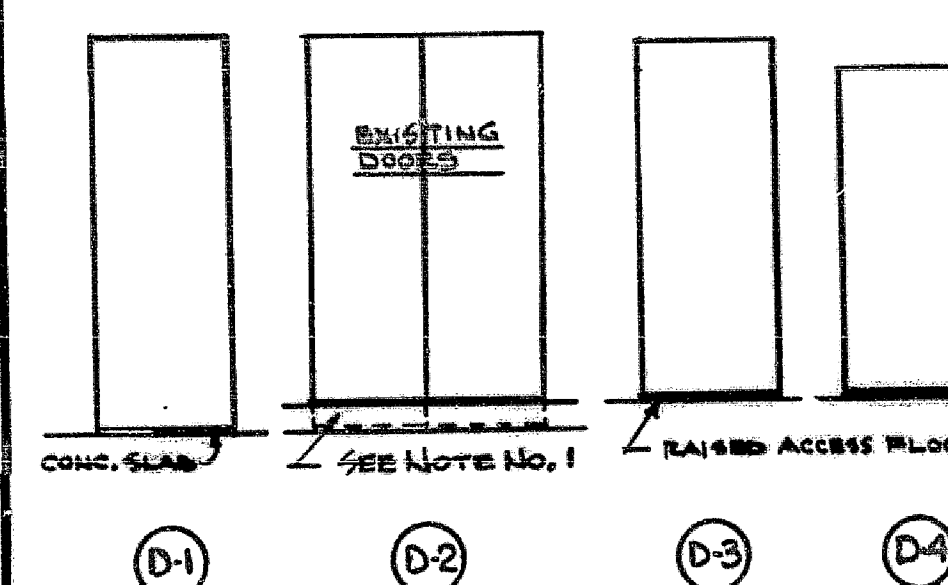

FRAME DETAILS

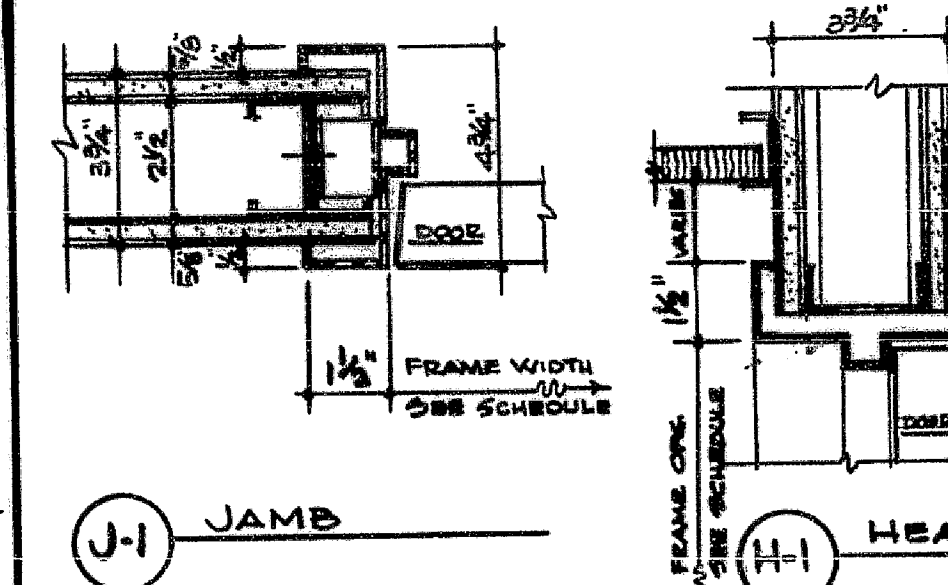

DOOR HARDWARE LISTING

SEE DWG. 105P-1 FOR ADDITIONAL HARDWARE NOTES

HINGES

- B-1 (2) PAIR STANLEY FBB-175, 4 1/2" x 3 1/2" U.S.P. FINISH
- B-2 (1/2) PAIR STANLEY FBB-175, 4 1/2" x 3 1/2" U.S.P. FINISH

LOCK & LATCHSETS

- L-1 LOCKSET COZBIN NO. 953 L MORTISE LOCK WITH NO. 705 L LEVEL HANDLE U.S. 2&D FINISH

CLOSERS

- C-1 SURFACE MOUNTED CLOSER W/O HO DORMA #7600 U.S.P. FINISH

MISCELLANEOUS

- M-1 DOWN FLOOR STOP GYNN JOHNSON GJ FB-13 OR GJ FB-14 AS REQUIRED, OR APPROVED EQUAL

DOOR & HARDWARE SCHEDULE NOTES

- REMOVE EXISTING DOUBLE DOORS CUT BOTTOM & EXISTING FLUSH BOLT TOP TO HEIGHT REQUIRED TO CLEAR NEW RAISED FLOOR. REBUILD DOOR BOTTOM & RE-INSTALL.
- ALL DOOR FRAMES SHALL BE PROVIDED WITH GYNN JOHNSON GJ-64 DOOR SILENCERS

ADDITIONAL REFERENCE DRAWINGS

- 105P-1 ADDITIONAL NOTES RAISED ACCESS FLOOR SPECIFICATIONS
- 105P-4 DEMOLITION & REMOVAL PLAN
- 105P-6 PARTITION DETAILS


KEY PLAN

1/8" = 1'-0"

PHASE

P

T.A.A. NO. W91051

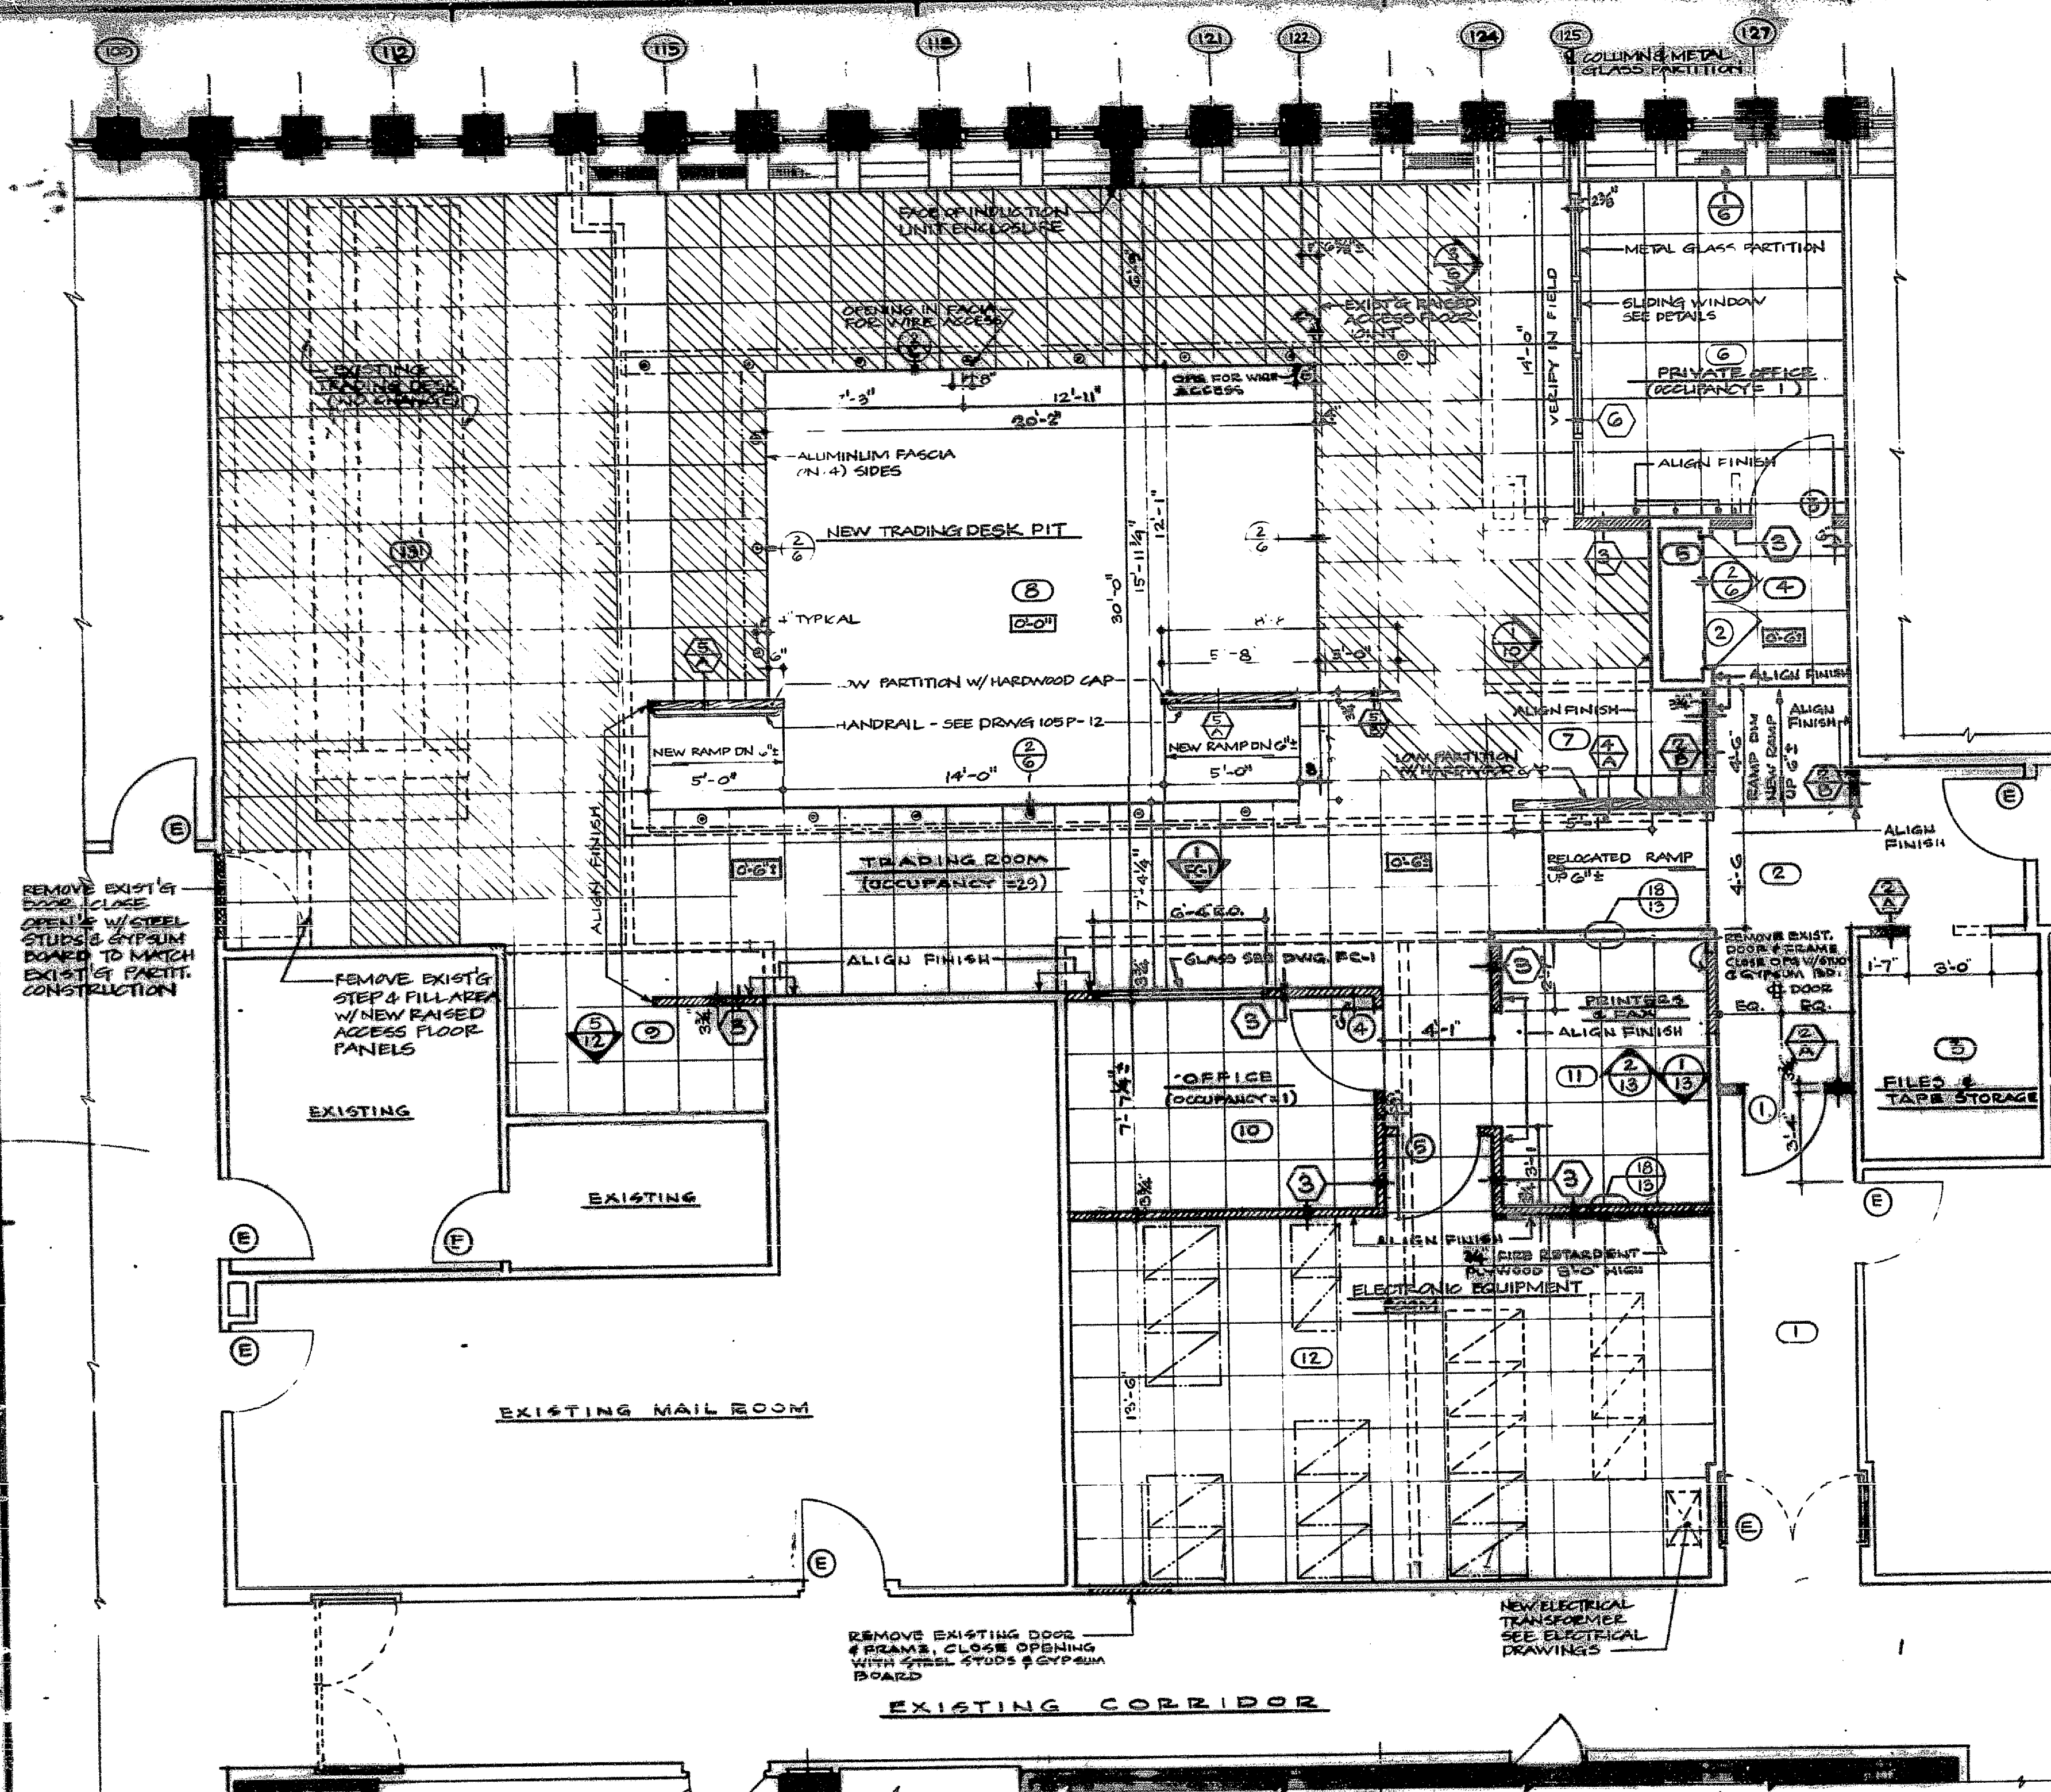

PART PLAN 105TH FLOOR
@ 1/4" = 1'-0"

DOOR & HARDWARE SCHEDULE

DOOR & HARDWARE																									
FLOOR	NO.	LOCATION		FRAME						DOOR						SADDLE		REMARKS	HARDWARE					NO.	
		FROM	TO	SWING	TYPE	DETAIL	WIDTH	HEIGHT	MAT'L	FURNISH BY	TYPE	THICK.	MAT'L	RATING LABEL	UNDO CUT	FURNISH BY	TYPE		MAT'L	HINGE	LOCK LATCH	CLOS.	SLIDE		MISC.
105TH FLOOR	1	2	1	LHR	F-1	J-1 H-1	3'-0"	6'-5 1/2"	H.M.	G.C.	D-1	1 3/4"	H.M.	—	3/4"	G.C.	S-2	VINYL	B-1	L-1	C-1	—	M-1	1	
	2	5	4	PAIR	EXIST.	EXIST.	5'-0"	EXIST. ONE DIMENSION	EXIST. H.M.	EXIST.	D-2	1 3/4"	EXIST. H.M.	—	3/4"	EXIST. G.C.	S-3	ALUM.	EXISTING HARDWARE SEE NOTE NO.1					2	
	3	4	6	RH	F-2	J-1 H-1	3'-0"	7'-9"	H.M.	G.C.	D-3	1 3/4"	H.M.	—	3/4"	G.C.	—	—	B-1	L-1	—	—	M-1	3	
	4	11	10	RH	F-3	J-1 H-1	3'-0"	7'-0"	H.M.	G.C.	D-4	1 3/4"	H.M.	—	3/4"	G.C.	—	—	B-2	L-1	—	—	M-1	4	
	5	11	12	RH	F-3	J-1 H-1	3'-0"	7'-0"	H.M.	G.C.	D-4	1 3/4"	H.M.	—	3/4"	G.C.	S-1	ALUM.	B-2	L-1	C-1	—	M-1	5	